


SCALE:
75' 0' 150' 300'

JAN. 2003

Wildcat Loadout
Surface Facilities
As Constructed
Plate 1

ACAD REF: Plate 1

RECEIVED
JUN 30 2005
DIV. OF OIL, GAS & MINING

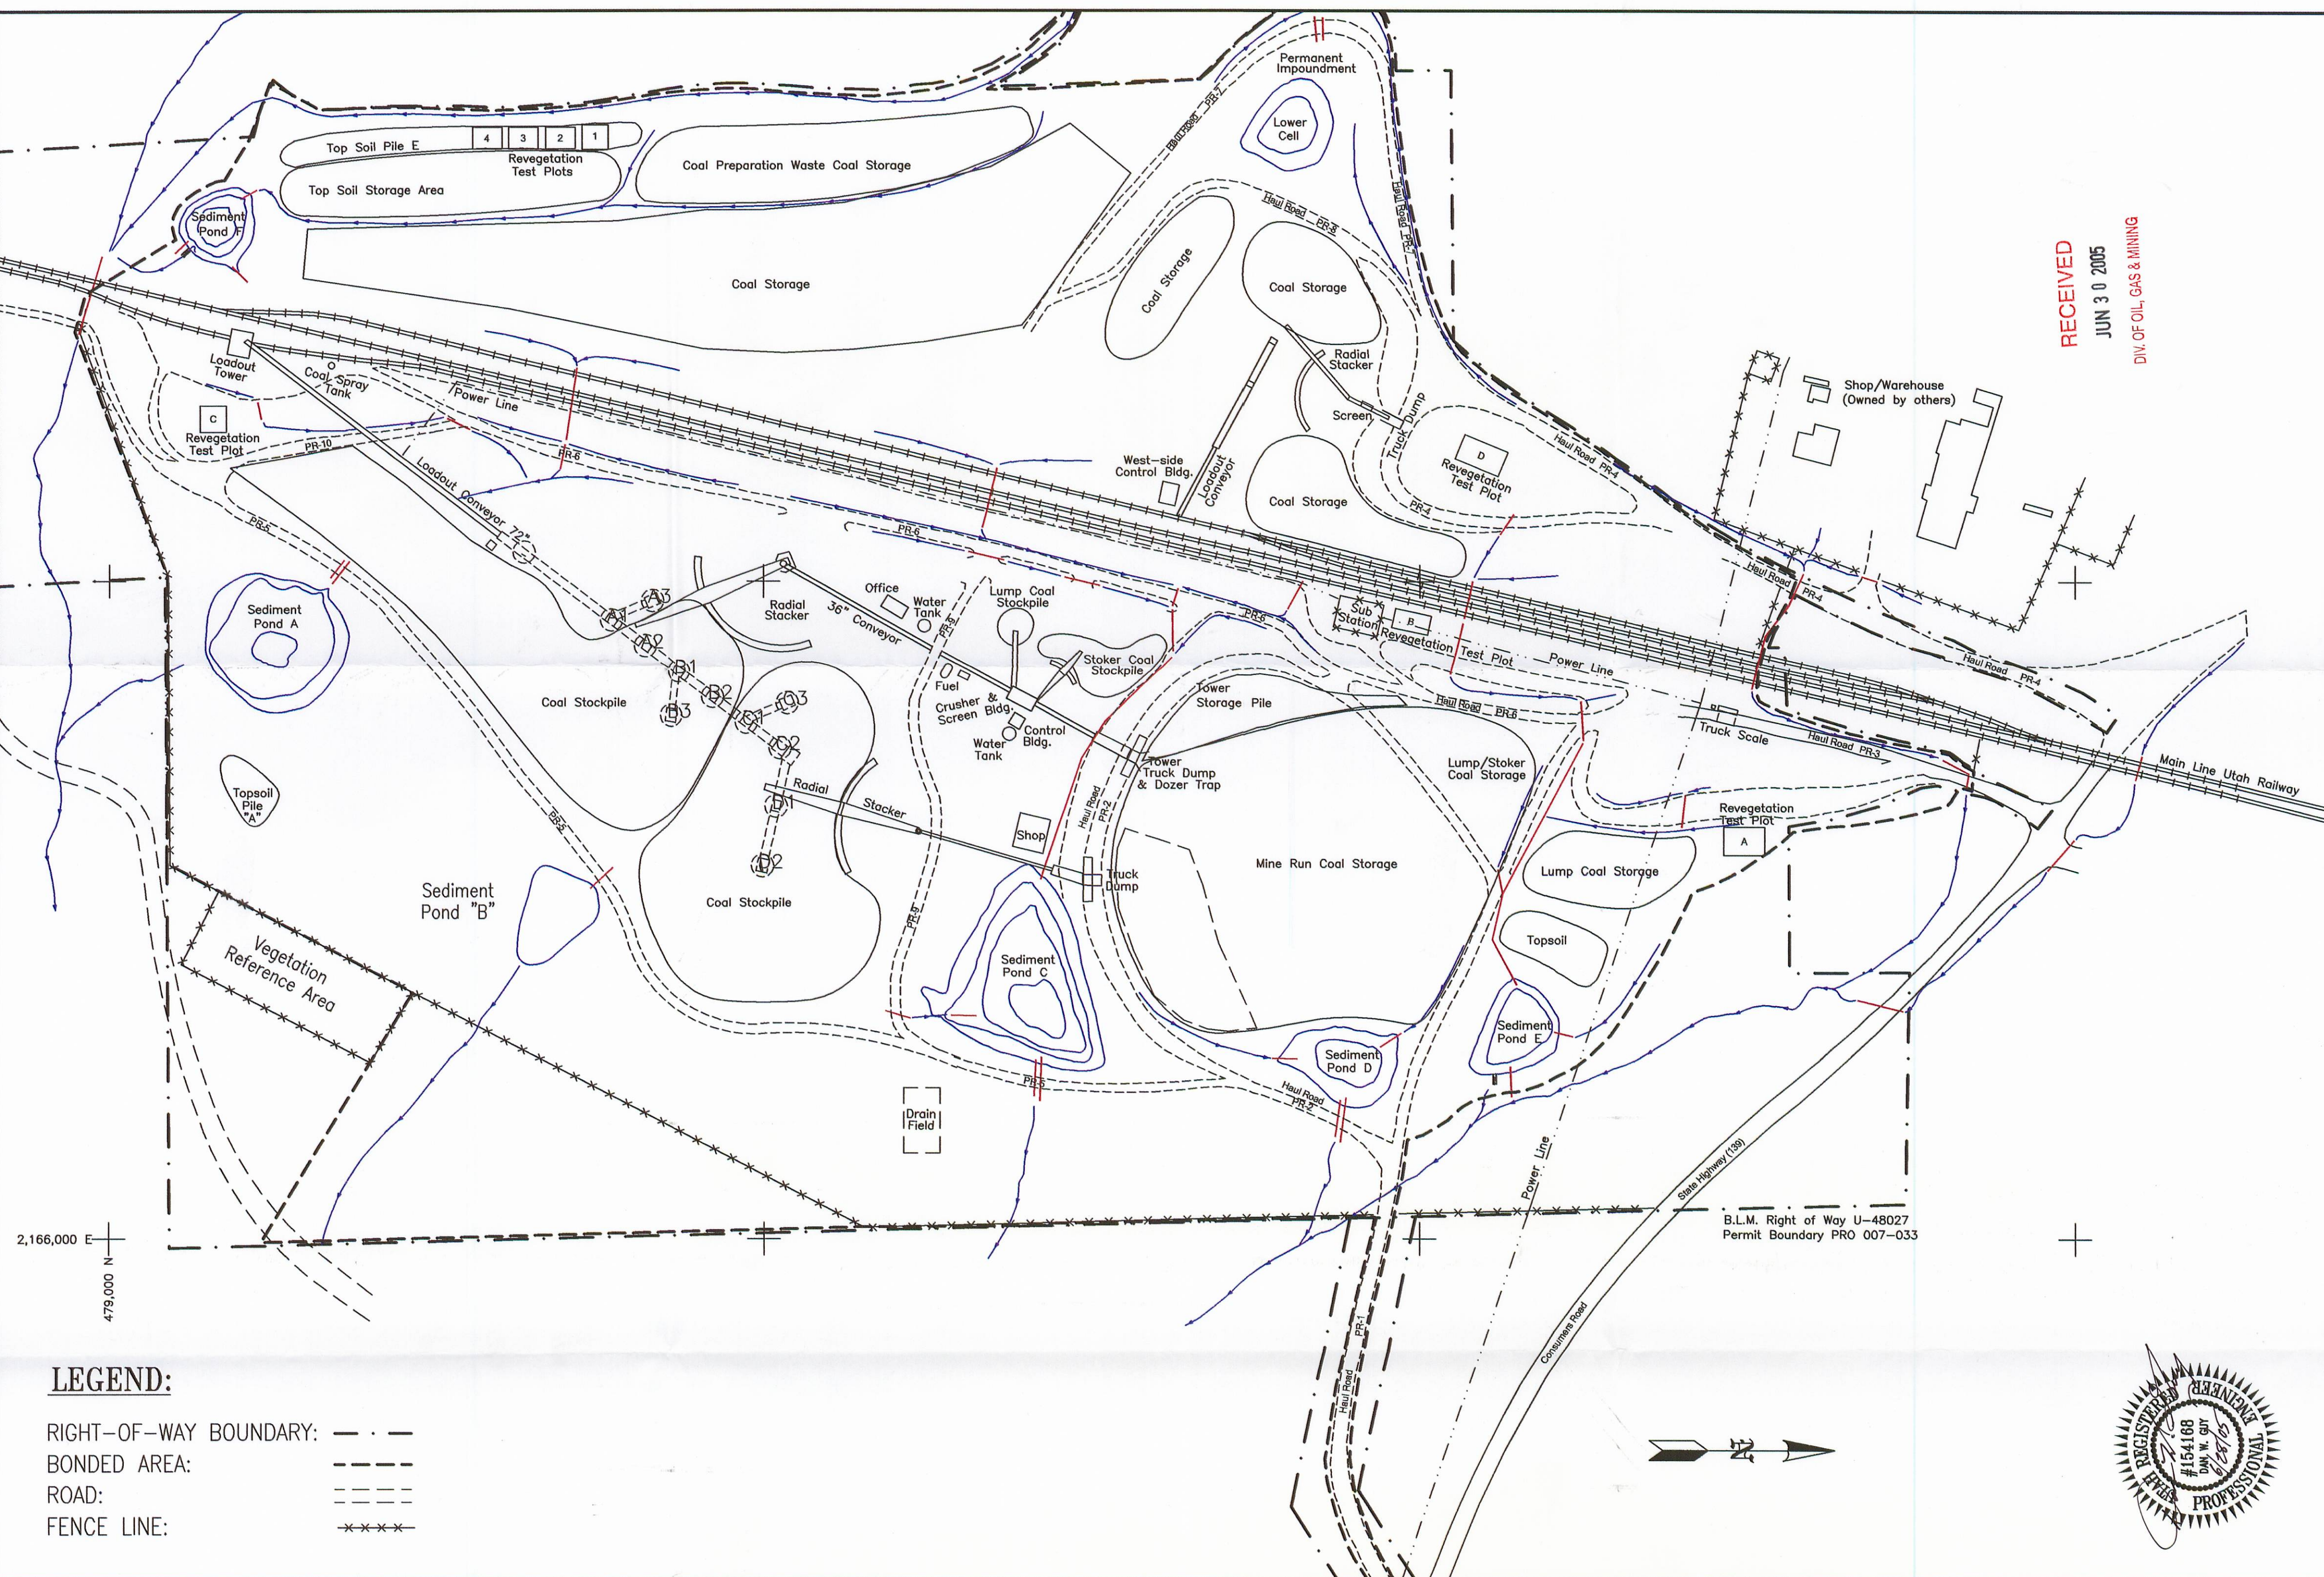

LEGEND:
RIGHT-OF-WAY BOUNDARY: - . -
BONDED AREA: - - -
ROAD: - - -
FENCE LINE: x x x x



B.L.M. Right of Way U-48027
Permit Boundary PRO 007-033